

STATE ENGINEER  
Salem, Oregon

LANE  
8110

# Well Record

STATE WELL NO. 16/4W-22K  
COUNTY LANE  
APPLICATION NO. GR-2797

OWNER: Delmar N. Loffelmacher


MAILING ADDRESS: 2951 Riverroad

LOCATION OF WELL: Owner's No.

CITY AND STATE: Eugene, Oregon

NW 1/4 SE 1/4 Sec. 22 T. 16 N. S., R. 4 W., W.M.

Bearing and distance from section or subdivision corner 2770' S. and 2250' W.

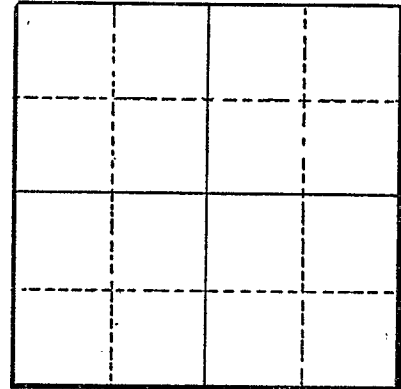

Section .....

Altitude at well .....

TYPE OF WELL: driven Date Constructed 1951

Depth drilled 22 Depth cased 22

### CASING RECORD:

4-inch

### FINISH:

Standard perforations from 18 to 22

### AQUIFERS:

Loam (Topsoil), sand and gravel

### WATER LEVEL:

9-feet

PUMPING EQUIPMENT: Type Berkeley Centrifugal H.P. 15  
Capacity 350 G.P.M.

### WELL TESTS:

Drawdown 3 ft. after ..... hours Pumping 360 G.P.M.  
Drawdown ..... ft. after ..... hours ..... G.P.M.

USE OF WATER irrigation Temp. °F. 19

SOURCE OF INFORMATION GR-2641

DRILLER or DIGGER .....

### ADDITIONAL DATA:

Log <sup>x</sup> Water Level Measurements ..... Chemical Analysis ..... Aquifer Test .....

### REMARKS:

Loam (topsoil) 6 16  
Sand and gravel 16 0