

STATE ENGINEER
Salem, Oregon

LANE
8114

Well Record

GR- 1303

STATE WELL NO. 16/4M-22E(2)
COUNTY Lane
APPLICATION NO. GR-1347

OWNER: Jesse J. or Elizabeth W. Smitson


MAILING ADDRESS: 5202 River Rd.

LOCATION OF WELL: Owner's No.

CITY AND STATE: Junction City, Oregon

SE 1/4 SW 1/4 Sec. 22 T. 16 S. R. 4 W., W.M.

Bearing and distance from section or subdivision corner 2550' N52°W. to NW cor. DIC #46.

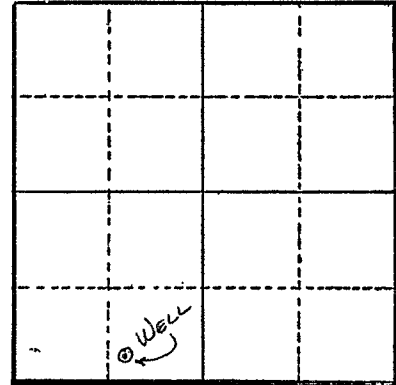

Section 22

Altitude at well 340 ft.

TYPE OF WELL: Drilled Date Constructed 1945

Depth drilled 20 ft. Depth cased

CASING RECORD:

4 in.

FINISH:

Perforated from 16 to 20 ft.

AQUIFERS:

WATER LEVEL:

12 ft.

PUMPING EQUIPMENT: Type Rain-O-Flow Cent. 3 x 4 in. H.P. 15
Capacity 350 G.P.M.

WELL TESTS:

Drawdown ft. after hours G.P.M.
Drawdown ft. after hours G.P.M.

USE OF WATER Irrigation Temp. °F., 19

SOURCE OF INFORMATION G. R. Record

DRILLER or DIGGER

ADDITIONAL DATA:

Log N.A. Water Level Measurements Chemical Analysis Aquifer Test

REMARKS:

Irrigation of 12 acres.