

STATE ENGINEER  
Salem, Oregon

LANE  
8115

# Well Record

STATE WELL NO. 16/4W-22Q  
COUNTY Lane  
APPLICATION NO. GR-1263

GR- 1219

OWNER: Clarence & Hazel Bond


MAILING ADDRESS: 6265 River Rd.

LOCATION OF WELL: Owner's No. #1

CITY AND STATE: Junction City, Oregon

SW 1/4 SE 1/4 Sec. 22 T. 16 S., R. 4 W., W.M.

Bearing and distance from section or subdivision  
corner 12 ch. N. & 27 ch. W. from SE cor. Sec. 22.

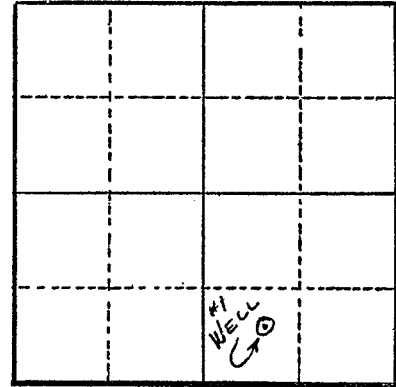

Section 22

Altitude at well 353 ft.

TYPE OF WELL: Driven Date Constructed 1954

Depth drilled 32 ft. Depth cased 32 ft.

CASING RECORD:  
4 inch

### FINISH:

Perforated: 1/4 x 5 in. - 12 slots from 27 to 32 ft.

### AQUIFERS:

WATER LEVEL:  
12 ft.

PUMPING EQUIPMENT: Type Berkeley H.P. 15  
Capacity 300 G.P.M.

### WELL TESTS:

Drawdown 6 ft. after 325 hours G.P.M.  
Drawdown ft. after hours G.P.M.

USE OF WATER Irrigation Temp. °F., 19

SOURCE OF INFORMATION G. R. Record

DRILLER or DIGGER

### ADDITIONAL DATA:

Log N.A. Water Level Measurements Chemical Analysis Aquifer Test

### REMARKS:

Irrigation of 19.73 acres.