

STATE ENGINEER  
Salem, Oregon

LANE  
8116

# Well Record

STATE WELL NO. 16/4W-22R  
COUNTY Lane  
APPLICATION NO. GR-3766

OWNER: S. P. Hughes

MAILING

ADDRESS: 440 Lone Pine Drive

LOCATION OF WELL: Owner's No.


CITY AND

STATE: Junction City, Oregon

SE 1/4 SE 1/4 Sec. 22 T. 16 S., R. 4 W., W.M.

Bearing and distance from section or subdivision

corner 3085 ft. S. 59° 30' W. of center of Sec. 23

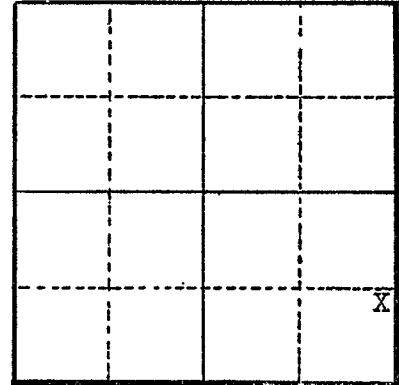

Section 22

Altitude at well

TYPE OF WELL: Driven Date Constructed June, 1937

Depth drilled 26 feet Depth cased 26 feet

### CASING RECORD:

4 inch black pipe set to 26 feet

### FINISH:

4 inch pipe perforated 4 feet from the end

### AQUIFERS:

### WATER LEVEL:

16 feet below surface

PUMPING EQUIPMENT: Type Berkeley centrifugal H.P. 15  
Capacity 500 G.P.M.

### WELL TESTS:

Drawdown ft. after hours G.P.M.

Drawdown ft. after hours G.P.M.

USE OF WATER Irrigation Temp. °F. 19

SOURCE OF INFORMATION Well Registration Statement

DRILLER or DIGGER

### ADDITIONAL DATA:

Log  Water Level Measurements  Chemical Analysis  Aquifer Test

### REMARKS:

Log:

Sandy loam  
Sand & gravel

Thickness	Depth to Bottom
12	14
14	0