

STATE ENGINEER
Salem, Oregon

LANE
8129

Well Record

STATE WELL NO. 16/4W-23C
COUNTY Lane
APPLICATION NO. GR-3664

OWNER: Donald J. Reetz

MAILING

ADDRESS: Route 2


LOCATION OF WELL: Owner's No.

CITY AND

STATE: Junction City, Oregon

NE 1/4 NW 1/4 Sec. 23 T. 16 N. S. R. 4 E. W., W.M.

Bearing and distance from section or subdivision
corner 300' S. & 600' W. of 1/4 sec. cor.

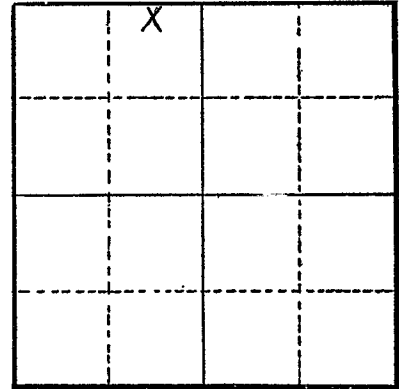

Section 23

Altitude at well

TYPE OF WELL: Driven Date Constructed 1949

Depth drilled 20 feet Depth cased 20 feet

CASING RECORD:

4 inch casing set to 20 feet

FINISH:

slotted perforations from 17 to 20 feet

AQUIFERS:

WATER LEVEL:

13 feet below surface

PUMPING EQUIPMENT: Type Fairbanks Morse centrifugal H.P. 10

Capacity 350 G.P.M.

WELL TESTS:

Drawdown ft. after hours G.P.M.

Drawdown ft. after hours G.P.M.

USE OF WATER Irrigation Temp. °F. 19

SOURCE OF INFORMATION Well Registration Statement

DRILLER or DIGGER

ADDITIONAL DATA:

Log Water Level Measurements Chemical Analysis Aquifer Test

REMARKS:

3360