

LANE
8130

Well Record

OWNER: Carl Kirk

MAILING

ADDRESS: 1120 Maple Drive


LOCATION OF WELL: Owner's No.

CITY AND

STATE: Junction City, Oregon

NE 1/4 NW 1/4 Sec. 23 T. 16 N. S, R. 4 E. W., W.M.

Bearing and distance from section or subdivision
corner 894' S. & 1056' W. of N 1/4 Cor. Sec. 23

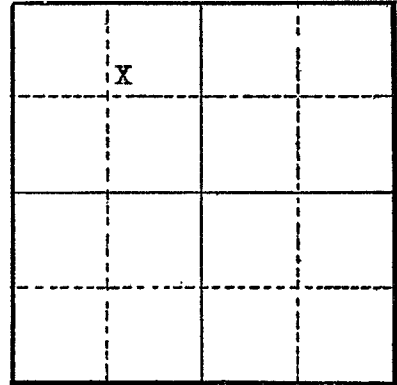

Section 23

Altitude at well

TYPE OF WELL: Driven Date Constructed 1942

Depth drilled 20 feet Depth cased 20 feet

CASING RECORD:

3 - 3" steel well casing set to 20 feet

FINISH:

slotted perforations 3" x 3" from 17 to 20 feet

AQUIFERS:

WATER LEVEL:

10 feet below surface

PUMPING EQUIPMENT: Type Allis Chalmers centrifugal H.P. 20
Capacity 400 G.P.M.

WELL TESTS:

Drawdown ft. after hours G.P.M.

Drawdown ft. after hours G.P.M.

USE OF WATER Irrigation Temp. °F., 19

SOURCE OF INFORMATION Well Registration Statement

DRILLER or DIGGER

ADDITIONAL DATA:

Log X Water Level Measurements Chemical Analysis Aquifer Test

REMARKS:

Log:

Gravel