


OWNER: Gracia R. Rottray
Leased to: Thayer Dickey
MAILING ADDRESS: 602 Maple Drive
CITY AND STATE: Junction City, Oregon

LOCATION OF WELL: Owner's No. 1
NW 1/4 NW 1/4 Sec. 23 T. 16 S., R. 4 W., W.M.

Bearing and distance from section or subdivision corner
South 61° 02' East 1250 feet from corner
common to Sections 14, 15, 22, and 23.

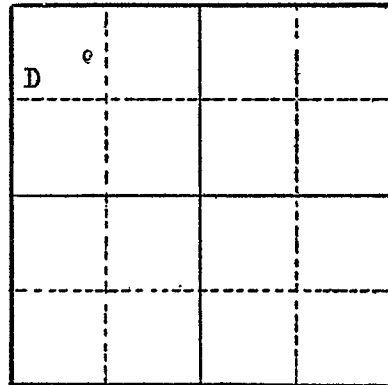

Section 23

Altitude at well

TYPE OF WELL: driven Date Constructed May 3, 1943
Depth drilled 21 feet Depth cased

CASING RECORD:

FINISH:
Drilled pipe
Six rows 3/8" holes 3' long

AQUIFERS:
loam, boulders, sand, and gravel

WATER LEVEL:
10 feet

PUMPING EQUIPMENT: Type Fairbanks Morse H.P.
Capacity 505 G.P.M.

WELL TESTS:
Drawdown ft. after hours 400 G.P.M.
Drawdown ft. after hours G.P.M.

USE OF WATER Irrigation Temp. °F., 19

SOURCE OF INFORMATION GR-4019

DRILLER or DIGGER

ADDITIONAL DATA:
Log Water Level Measurements Chemical Analysis Aquifer Test

REMARKS:

3' loam 18' boulders, sand, and gravel