


OWNER: Thayer Dickey MAILING ADDRESS: 602 Maple Drive

LOCATION OF WELL: Owner's No. CITY AND STATE: Junction City, Oregon

NW 1/4 NW 1/4 Sec. 23 T. 16 S., R. 4 W., W.M.
Bearing and distance from section or subdivision
corner South 47° 45' East 850 feet from the corner
common to Section 14, 15, 22, and 23.

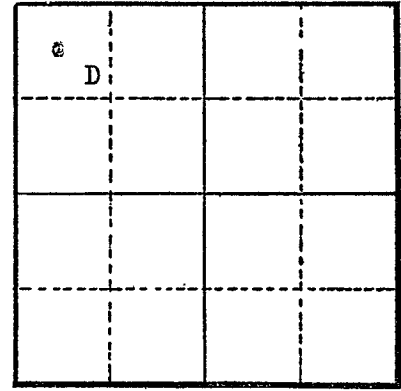

Altitude at well

TYPE OF WELL: Driven Date Constructed 4-7-37

Depth drilled 21 feet Depth cased

Section 23

CASING RECORD:

FINISH:

Drilled pipe
Six rows 3/8" holes 3' long

AQUIFERS:

loam, boulders, rock, and sand

WATER LEVEL:

8 feet

PUMPING EQUIPMENT: Type Fairbanks-Morse 4" 3" discharge H.P.

Capacity 505 G.P.M.

WELL TESTS:

Drawdown ft. after hours 500 G.P.M.
Drawdown ft. after hours G.P.M.

USE OF WATER Irrigation Temp. °F. 19

SOURCE OF INFORMATION GR-4021

DRILLER or DIGGER

ADDITIONAL DATA:

Log X Water Level Measurements Chemical Analysis Aquifer Test

REMARKS:

7' loam 14' boulders, rock & sand