

STATE ENGINEER
Salem, Oregon

LANE Well Record

8133

STATE WELL NO. 16/4W-23E
COUNTY LANE
APPLICATION NO. GR-2798

OWNER: Delmar N. Loffelmacher


MAILING ADDRESS: 2951 Riverroad

LOCATION OF WELL: Owner's No. _____

CITY AND STATE: Eugene, Oregon

SW 1/4 NW 1/4 Sec. 23 T. 16 ^{N.} S., R. 4 ^{E.} W., W.M.

Bearing and distance from section or subdivision corner 2420' S. and 40' E.

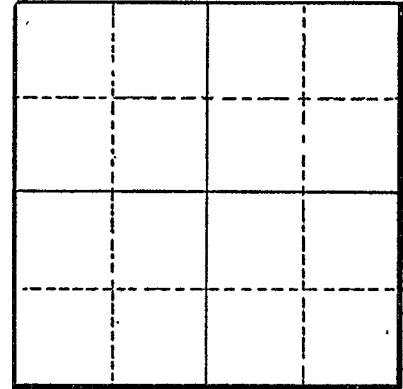

Section _____

Altitude at well _____

TYPE OF WELL: driven Date Constructed 1946

Depth drilled 21 Depth cased 21

CASING RECORD:

(2) - 3-inch

FINISH:

Standard perforations from 17 to 21

AQUIFERS:

Loam, topsoil, sand and gravel

WATER LEVEL:

9-feet

PUMPING EQUIPMENT: Type Berkeley Centrifugal H.P. 10
Capacity 350 G.P.M.

WELL TESTS:

Drawdown 3 ft. after _____ hours Pumping 400 G.P.M.

Drawdown _____ ft. after _____ hours _____ G.P.M.

USE OF WATER irrigation Temp. _____ °F., 19 _____

SOURCE OF INFORMATION GR-2642

DRILLER or DIGGER _____

ADDITIONAL DATA:

Log Water Level Measurements _____ Chemical Analysis _____ Aquifer Test _____

REMARKS:

Loam (topsoil) 6 15
Sand and gravel 15 0