

OWNER: Carl Kirk

MAILING

ADDRESS: 1120 Maple Drive

LOCATION OF WELL: Owner's No.


CITY AND

STATE: Junction City, Oregon

SE 1/4 NW 1/4 Sec. 23 T. 16 S., R. 4 W., W.M.

Bearing and distance from section or subdivision

corner 2348' S. & 165' W. of N 1/4 Cor. Sec. 23

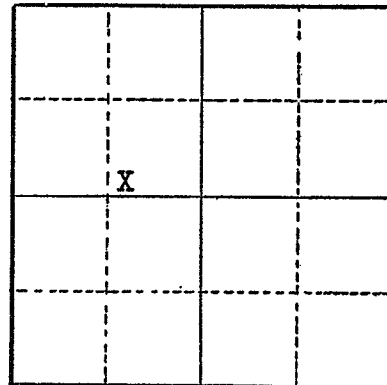

Section 23

Altitude at well

TYPE OF WELL: Driven Date Constructed 1943

Depth drilled 20 feet Depth cased 20 feet

CASING RECORD:

4 inch steel well casing set to 20 feet

FINISH:

AQUIFERS:

WATER LEVEL:

PUMPING EQUIPMENT: Type 2" centrifugal H.P. 5
Capacity 100 G.P.M.

WELL TESTS:

Drawdown ft. after hours G.P.M.

Drawdown ft. after hours G.P.M.

USE OF WATER Irrigation Temp. °F. 19

SOURCE OF INFORMATION Well Registration Statement

DRILLER or DIGGER

ADDITIONAL DATA:

Log X Water Level Measurements Chemical Analysis Aquifer Test

REMARKS:

Log:

Gravel