

STATE ENGINEER
Salem, Oregon

Well Record

STATE WELL NO. 16/4W-23F
COUNTY Lane
APPLICATION NO. GR-3757


LANE
8135

OWNER: Carl Kirk MAILING ADDRESS: 1121 Maple Drive

LOCATION OF WELL: Owner's No. _____ CITY AND STATE: Junction City, Oregon

SE 1/4 NW 1/4 Sec. 23 T. 16 S., R. 4 W., W.M.

Bearing and distance from section or subdivision corner 2275' S. & 560' W. of N 1/4 Cor. Sec. 23

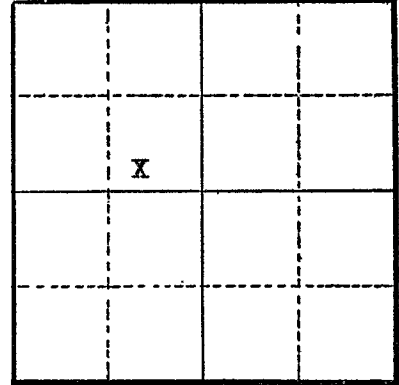

Section 23

Altitude at well _____

TYPE OF WELL: Driven Date Constructed 1952

Depth drilled 20 feet Depth cased 20 feet

CASING RECORD:

2 - 3" steel well casing set to 20 feet

FINISH:

AQUIFERS:

WATER LEVEL:

PUMPING EQUIPMENT: Type Centrifugal 2" H.P. 5
Capacity 100 G.P.M.

WELL TESTS:

Drawdown _____ ft. after _____ hours _____ G.P.M.
Drawdown _____ ft. after _____ hours _____ G.P.M.

USE OF WATER Irrigation Temp. _____ °F., 19 _____

SOURCE OF INFORMATION Well Registration Statement

DRILLER or DIGGER _____

ADDITIONAL DATA:

Log X Water Level Measurements _____ Chemical Analysis _____ Aquifer Test _____

REMARKS:

Log:
Gravel