

STATE ENGINEER
Salem, Oregon

LANE
8139

Well Record

STATE WELL NO. 16/4W-23L(3)
COUNTY Lane
APPLICATION NO. GR-304


OWNER: Della B. Young
MAILING ADDRESS: Rt. 2, Box 69

LOCATION OF WELL: Owner's No. 1
CITY AND STATE: Junction City, Oregon

NE 1/4 SW 1/4 Sec. 23 T. 16 N S. R. 4 W, W.M.

Bearing and distance from section or subdivision
corner 1380 ft. S. 65° 18' E. to NE cor. Geo. Evans

DLC 46 in Sec. 23

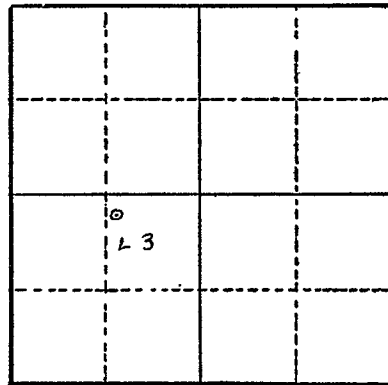

Section 23

Altitude at well 352 ft. Interpolated

TYPE OF WELL: driven Date Constructed May 1950

Depth drilled 20 ft. Depth cased 20 ft.

CASING RECORD: 4 - in. casing set from 0 to 20 ft.

FINISH: 3 ft. well point - slotted. 3/8" x 6" slots, spaced 6" vertically, 90° horiz.

AQUIFERS: Sand & gravels from 6 to 20 ft.

WATER LEVEL: 10 ft. below land surface

PUMPING EQUIPMENT: Type A. C. centrifugal 3" x 3" H.P. 15
Capacity 350 G.P.M.

WELL TESTS:
Drawdown ft. after hours G.P.M.
Drawdown ft. after hours G.P.M.

USE OF WATER irrigation 12.1 acres Temp. °F. 19

SOURCE OF INFORMATION Reg. State. GR-304

DRILLER or DIGGER

ADDITIONAL DATA:
Log Water Level Measurements Chemical Analysis Aquifer Test

REMARKS: Log: Loam 0 to 6 ft.
Sand & gravel 6 to 16 ft.
Sand & gravel large 12 to 20 ft.