

STATE ENGINEER
Salem, Oregon

LANE
8140

Well Record


STATE WELL NO. 16/4W-23M
COUNTY Lane
APPLICATION NO. GR-3764

OWNER: S. P. Hughes
MAILING ADDRESS: 599 Lone Pine Drive

LOCATION OF WELL: Owner's No. _____
CITY AND STATE: Junction City, Oregon

NW 1/4 SW 1/4 Sec. 23 T. 16 N. S., R. 4 E. W., W.M.

Bearing and distance from section or subdivision
corner 2175' S. 80° W. of the center Sec. 23

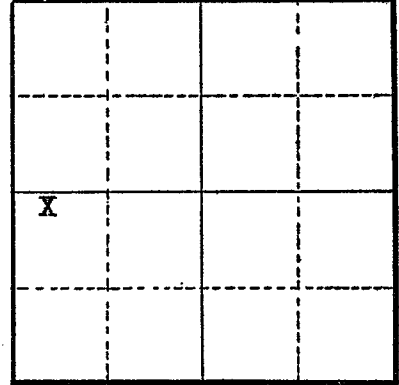

Section 23

Altitude at well _____

TYPE OF WELL: Driven Date Constructed _____

Depth drilled 25 feet Depth cased 25 feet

CASING RECORD:

3 inch black pipe casing set to 25 feet

FINISH:

Well was in when place was purchased

AQUIFERS:

WATER LEVEL:

10 feet below surface

PUMPING EQUIPMENT: Type Homart centrifugal 2" H.P. 6
Capacity 120 G.P.M.

WELL TESTS:

Drawdown _____ ft. after _____ hours _____ G.P.M.
Drawdown _____ ft. after _____ hours _____ G.P.M.

USE OF WATER Irrigation Temp. °F. _____, 19

SOURCE OF INFORMATION Well Registration Statement

DRILLER or DIGGER _____

ADDITIONAL DATA:

Log _____ Water Level Measurements _____ Chemical Analysis _____ Aquifer Test _____

REMARKS:

3425