

LANE
8141

Well Record

OWNER: Bud Andrews


MAILING ADDRESS: Box 724 Lone Pine Drive

LOCATION OF WELL: Owner's No. #2

CITY AND STATE: Junction City, Oregon

NW 1/4 SW 1/4 Sec. 23 T. 16 N. S. R. 4 E. W., W.M.

Bearing and distance from section or subdivision corner 1460' W. and 1400' N.

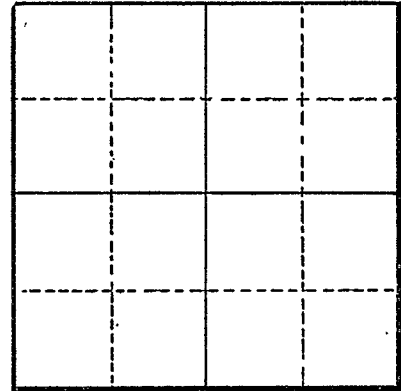

Section

Altitude at well

TYPE OF WELL: drove Date Constructed 1940

Depth drilled 21 Depth cased 21

CASING RECORD:

4-inch

FINISH:

Slotted from 18 to 21

AQUIFERS:

WATER LEVEL:

16-feet

PUMPING EQUIPMENT: Type Fairbanks Morse H.P. 30
Capacity 300 G.P.M.

WELL TESTS:

Drawdown ft. after hours G.P.M.
Drawdown ft. after hours G.P.M.

USE OF WATER irrigation Temp. °F., 19

SOURCE OF INFORMATION GR-2672

DRILLER or DIGGER

ADDITIONAL DATA:

Log Water Level Measurements Chemical Analysis Aquifer Test

REMARKS: