

STATE ENGINEER  
Salem, Oregon


LANE  
8142

# Well Record

STATE WELL NO. 16/4W-23N  
COUNTY Lane  
APPLICATION NO. GR-3765

OWNER: S. P. Hughes MAILING ADDRESS: 440 Lone Pine Drive  
CITY AND STATE: Junction City, Oregon

LOCATION OF WELL: Owner's No. \_\_\_\_\_  
SW 1/4 SW 1/4 Sec. 23 T. 16 S., R. 4 W., W.M.  
Bearing and distance from section or subdivision  
corner 3570' S. 46° 35' W. of center of Sec. 23

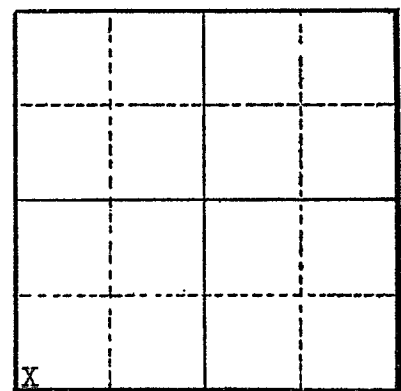

Altitude at well \_\_\_\_\_

TYPE OF WELL: Driven Date Constructed June, 1939

Depth drilled 26 feet Depth cased 26 feet

Section 23

### CASING RECORD:

4 inch black pipe casing set to 26 feet

### FINISH:

4 inch black pipe perforated 4 feet from the end

### AQUIFERS:

### WATER LEVEL:

16 feet below surface

PUMPING EQUIPMENT: Type Fairbanks Morse & Co. centrifugal H.P. 30  
Capacity 500 G.P.M.

### WELL TESTS:

Drawdown \_\_\_\_\_ ft. after \_\_\_\_\_ hours \_\_\_\_\_ G.P.M.  
Drawdown \_\_\_\_\_ ft. after \_\_\_\_\_ hours \_\_\_\_\_ G.P.M.

USE OF WATER Irrigation Temp. \_\_\_\_\_ °F. \_\_\_\_\_, 19\_\_\_\_

SOURCE OF INFORMATION Well Registration Statement

DRILLER or DIGGER \_\_\_\_\_

### ADDITIONAL DATA:

Log X Water Level Measurements \_\_\_\_\_ Chemical Analysis \_\_\_\_\_ Aquifer Test \_\_\_\_\_

### REMARKS:

Log: Sandy loam & clay Thickness 20 Depth to Bottom 6  
Sand & gravel 6 0