

STATE ENGINEER  
Salem, Oregon

LANE  
8144

# Well Record

STATE WELL NO. 16/LW-23N  
COUNTY LANE  
APPLICATION NO. GR-2835

OWNER: Bud Andrews


MAILING ADDRESS: Box 724 Lone Pine Drive

LOCATION OF WELL: Owner's No. #1

CITY AND STATE: Junction City, Oregon

SW 1/4 SW 1/4 Sec. 23 T. 16 N. 4 E. S., R. 4 W., W.M.

Bearing and distance from section or subdivision corner 1460' W. and 410' N.

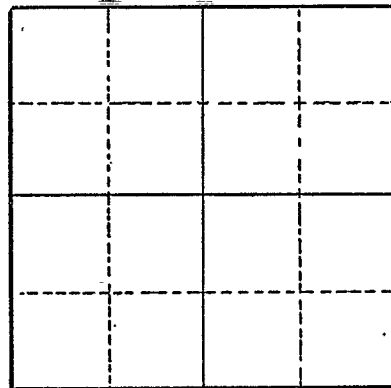

Section

Altitude at well

TYPE OF WELL: drove Date Constructed 1944

Depth drilled 25 Depth cased 25

### CASING RECORD:

4-inch

### FINISH:

Slotted from 22 to 25

### AQUIFERS:

### WATER LEVEL:

16-feet

PUMPING EQUIPMENT: Type Fairbanks Morse H.P. 30  
Capacity 300 G.P.M.

### WELL TESTS:

Drawdown ft. after hours G.P.M.  
Drawdown ft. after hours G.P.M.

USE OF WATER irrigation Temp. °F. 19

SOURCE OF INFORMATION GR-2671

DRILLER or DIGGER

### ADDITIONAL DATA:

Log Water Level Measurements Chemical Analysis Aquifer Test

### REMARKS: