

LANE
8145

Well Record

OWNER: Fred A. Loffelmacher


MAILING ADDRESS: 898 Lone Pine Dr.

LOCATION OF WELL: Owner's No.

CITY AND STATE: Junction City, Oregon

SE 1/4 SW 1/4 Sec. 23 T. 16 N. S. R. 4 W., W.M.

Bearing and distance from section or subdivision corner 1710' E. and 840' N.

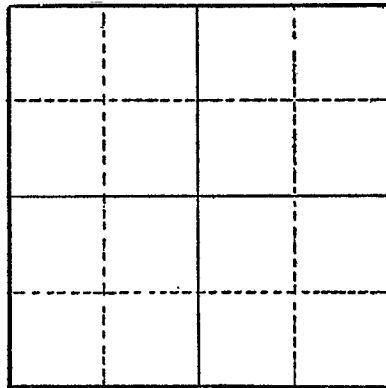

Section

Altitude at well

TYPE OF WELL: Driven Date Constructed 1954

Depth drilled 22' Depth cased 22'

CASING RECORD:

4"

FINISH:

3' of 4" perforated regular well casing from 19 to 22

AQUIFERS: sand and gravel
Silt loam
Sand

WATER LEVEL:

10'

PUMPING EQUIPMENT: Type Allis Chalmers H.P. 10
Capacity 250 G.P.M.

WELL TESTS:

Drawdown 3 ft. after hours pumping 250 G.P.M.
Drawdown ft. after hours G.P.M.

USE OF WATER Irrigation Temp. °F., 19

SOURCE OF INFORMATION GR-2941

DRILLER or DIGGER

ADDITIONAL DATA:

Log Water Level Measurements Chemical Analysis Aquifer Test

REMARKS:

silt loam 8 8
sand 4 12
sand & gravel 10 22