

STATE ENGINEER
Salem, Oregon

LANE
8148

Well Record

STATE WELL NO. 16/4W-23Q(1)
COUNTY Lane
APPLICATION NO. GR-303

OWNER: Orval R. & Frances M. Paeschke
MAILING ADDRESS: Rt. 2, Lone Pine Dr.

LOCATION OF WELL: Owner's No. 2
CITY AND STATE: Junction City, Oregon

SW 1/4 SE 1/4 Sec. 23 T. 16 N. S. R. 4 W., W.M.


Bearing and distance from section or subdivision
corner 1275.5 ft. N. 15° 47' W. to NE cor.
George Evans DLC 46

Altitude at well 355 ft. Interpolated

TYPE OF WELL: driven Date Constructed May 1950

Depth drilled 22 Depth cased

CASING RECORD: 4 - in. pipe set to 22 ft.

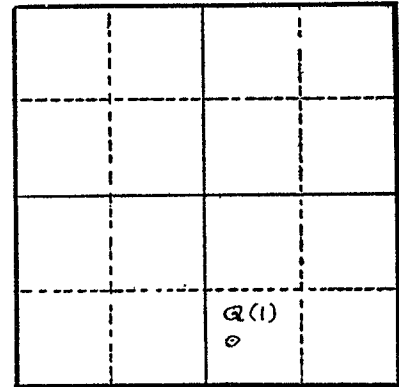

Section 23

FINISH: Well point 3 ft. long - torch cut slots 3/8" x 6" - spaced 6" vert.
spaced 90° horiz.
from 19 to 22 ft.

AQUIFERS: Sand & gravel from 6 to 22 ft.

WATER LEVEL: 6 ft. to 11 ft. below land surface during spring to summer

PUMPING EQUIPMENT: Type A. C. centrifugal H.P. 15
Capacity 350 G.P.M.

WELL TESTS:
Drawdown 7 ft. after hours pumping 350 G.P.M.
Drawdown ft. after hours G.P.M.

USE OF WATER Irrigation (24.2) acres Temp. °F. 19

SOURCE OF INFORMATION Reg. State. GR-303

DRILLER or DIGGER unknown

ADDITIONAL DATA:
Log X Water Level Measurements Chemical Analysis Aquifer Test

REMARKS: Log: Loam 0 to 6 ft.
Sand & gravel 6 to 10 ft.