

STATE ENGINEER  
Salem, Oregon

LANE  
8152

# Well Record

STATE WELL NO. 16/LW-24F(1)  
COUNTY Lane  
APPLICATION NO. GR-977

GR-947


OWNER: Green Brothers MAILING ADDRESS: Box 72

LOCATION OF WELL: Owner's No. #6 CITY AND STATE: Coburg, Oregon

SE 1/4 SW 1/4 Sec. 24 T. 16 S., R. 4 W., W.M.

Bearing and distance from section or subdivision

corner N50°48'W, 4472' from the E1/4 cor. Sec. 25.

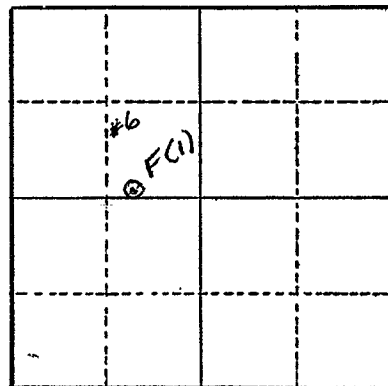

Section 24

Altitude at well 355 ft.

TYPE OF WELL: Dug Date Constructed 1950

Depth drilled 18 ft. Depth cased 18 ft.

### CASING RECORD:

Open hole	0 to 9 ft.
30 in. concrete	9 to 18 ft.

### FINISH:

### AQUIFERS:

### WATER LEVEL:

12 ft.

PUMPING EQUIPMENT: Type 4" x 3" Centrifugal H.P. 20  
Capacity 400 G.P.M.

### WELL TESTS:

Drawdown 4 ft. after hours 400 G.P.M.

Drawdown ft. after hours G.P.M.

USE OF WATER Irrigation Temp. °F., 19

SOURCE OF INFORMATION G.R. Record

DRILLER or DIGGER

### ADDITIONAL DATA:

Log Water Level Measurements Chemical Analysis Aquifer Test

### REMARKS:

Log: Medium sized gravel	0 to 16 ft.
Pea gravel	16 to 18 ft.

Irrigation of 32 acres.