

STATE ENGINEER  
Salem, Oregon

**LANE**  
853

# Well Record

STATE WELL NO. 16/4W-24E(2)  
COUNTY Lane  
APPLICATION NO. GR-1264

GR- 1220

OWNER: Harold G. & George R. Seifert

MAILING ADDRESS:

Rt. 2, Box 459


LOCATION OF WELL: Owner's No. #2

CITY AND STATE:

Eugene, Oregon

SE 1/4 NW 1/4 Sec. 24 T. 16 S. R. 4 W., W.M.

Bearing and distance from section or subdivision corner 690' N. & 2820' W. from SE cor. of NE 1/4 of Section 24.

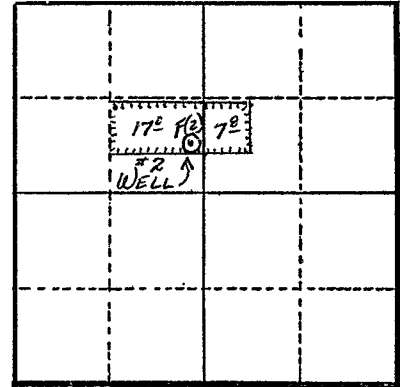

Section 24

Altitude at well 360 ±

TYPE OF WELL: Driven Date Constructed 1952

Depth drilled 20 ft. Depth cased 20 ft.

### CASING RECORD:

6 inch.

### FINISH:

Slotted perforations; 1/2 x 3 in. - 12 per ft. from 17 to 20 ft.

### AQUIFERS:

### WATER LEVEL:

10 ft.

PUMPING EQUIPMENT: Type Berkeley 4 x 5 in. Cent. H.P. 20

Capacity 450 G.P.M.

### WELL TESTS:

Drawdown ft. after hours G.P.M.

Drawdown ft. after hours G.P.M.

USE OF WATER Irrigation Temp. °F., 19

SOURCE OF INFORMATION G. R. Record

DRILLER or DIGGER

### ADDITIONAL DATA:

Log N.A. Water Level Measurements Chemical Analysis Aquifer Test

### REMARKS:

Irrigation of 24.8 acres.