

STATE ENGINEER
Salem, Oregon

LANE Well Record
8154 GR- 1604

STATE WELL NO. 16/4W-24G
COUNTY Lane
APPLICATION NO. GR- 1639

OWNER: Walter C. & Ethel Mae Chase


MAILING ADDRESS: Rt. 2

LOCATION OF WELL: Owner's No. #2

CITY AND STATE: Eugene, Oregon

SW 1/4 NE 1/4 Sec. 24 T. 16 S., R. 4 W., W.M.

Bearing and distance from section or subdivision corner 1830' N.71°W. from E 1/4 cor. Sec. 24

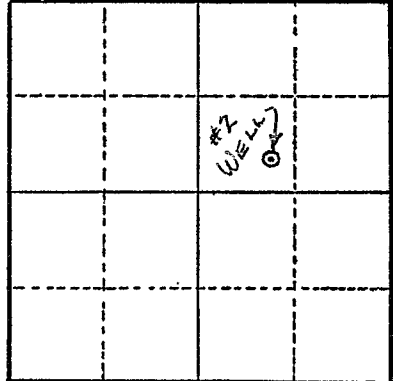

Section 24

Altitude at well 300'

TYPE OF WELL: Driven Date Constructed 1945

Depth drilled 24' Depth cased 24'

CASING RECORD:
4"

FINISH:
Perforated from 21 to 24 ft.

AQUIFERS:

WATER LEVEL:
12'

PUMPING EQUIPMENT: Type F. M. H.P. 45
Capacity 750 G.P.M.

WELL TESTS:
Drawdown ft. after hours G.P.M.
Drawdown ft. after hours G.P.M.

USE OF WATER Irrigation Temp. °F., 19

SOURCE OF INFORMATION GR Record

DRILLER or DIGGER

ADDITIONAL DATA:
Log N.A. Water Level Measurements Chemical Analysis Aquifer Test

REMARKS:
Irrigation of 10.5 acres.