

STATE ENGINEER
Salem, Oregon

LANE
8155

Well Record

STATE WELL NO. 16/4W-24G
COUNTY Lane
APPLICATION NO. GR-1640

GR- 1605

OWNER: Walter C. & Ethel Mae Chase


MAILING ADDRESS: Rt. 2

LOCATION OF WELL: Owner's No. #3

CITY AND STATE: Eugene, Oregon

SW 1/4 NE 1/4 Sec. 24 T. 16 S. R. 4 W., W.M.

Bearing and distance from section or subdivision corner 2650' N. 82°W. from E¹ cor. Sec. 24

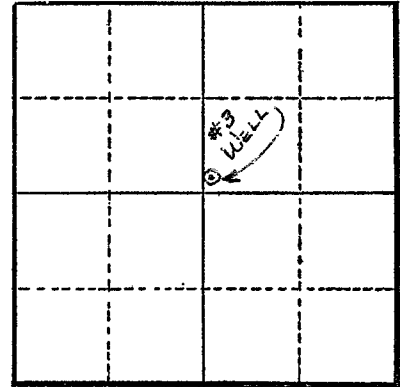

Section 24

Altitude at well 300'

TYPE OF WELL: Driven Date Constructed 1945

Depth drilled 22' Depth cased 22'

CASING RECORD:

5"

FINISH:

Perforated with slots from 19 to 22 ft.

AQUIFERS:

WATER LEVEL:

10'

PUMPING EQUIPMENT: Type F. M. 3" H.P. 45

Capacity 750 G.P.M.

WELL TESTS:

Drawdown ft. after hours G.P.M.

Drawdown ft. after hours G.P.M.

USE OF WATER Irrigation Temp. °F. 19

SOURCE OF INFORMATION GR Record

DRILLER or DIGGER

ADDITIONAL DATA:

Log N.A. Water Level Measurements Chemical Analysis Aquifer Test

REMARKS:

Irrigation of 17.8 acres.