

LANE  
8156

# Well Record

GR- 1221

OWNER: Harold G. & George R. Seifert

MAILING ADDRESS:

Rt. 2, Box 459

LOCATION OF WELL: Owner's No. #1


CITY AND STATE:

Eugene, Oregon

SE 1/4 NE 1/4 Sec. 24 T. 16 S, R. 4 W., W.M.

Bearing and distance from section or subdivision

corner 1050' W. & 680' N. from E 1/4 cor. Sec. 24.

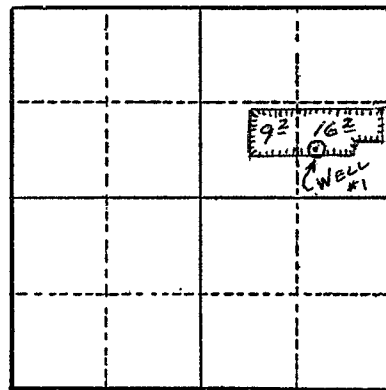

Section 24

Altitude at well 350 ft.

TYPE OF WELL: Driven Date Constructed 1949

Depth drilled 23 ft. Depth cased 23 ft.

### CASING RECORD:

4 inch

### FINISH:

Perforated; 1/4 x 3 in. slotted - 6 per ft. from 20 to 23 ft.

### AQUIFERS:

### WATER LEVEL:

10 ft.

PUMPING EQUIPMENT: Type Berkeley 4 x 5 in. Cent. H.P. 20  
Capacity 450 G.P.M.

### WELL TESTS:

Drawdown ft. after hours G.P.M.

Drawdown ft. after hours G.P.M.

USE OF WATER Irrigation Temp. °F., 19

SOURCE OF INFORMATION G. R. Record

DRILLER or DIGGER

### ADDITIONAL DATA:

Log N.A. Water Level Measurements Chemical Analysis Aquifer Test

### REMARKS:

Irrigation of 25.4 acres.