

LANE
8157

Well Record

GR- 1174

STATE WELL NO. 16/W-24J(1)
COUNTY Lane
APPLICATION NO. GR- 1214

OWNER: Robert S. & Myrtle G. Geer

MAILING

ADDRESS: Rt. 2, Box 461

LOCATION OF WELL: Owner's No.


CITY AND

STATE: Eugene, Oregon

NE 1/4 SE 1/4 Sec. 24 T. 16 S., R. 4 W., W.M.

Bearing and distance from section or subdivision

corner S10°45'W. 410' from E¹/₄ cor. Sec. 24.

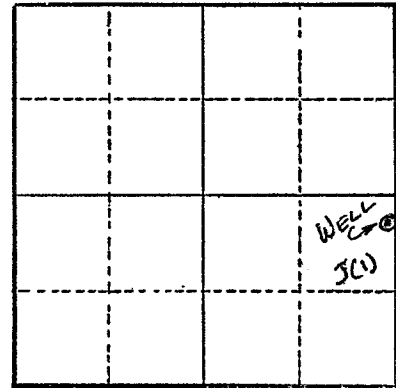

Section 24

Altitude at well 355 ft.

TYPE OF WELL: Driven Date Constructed 1946

Depth drilled 18 ft. Depth cased 18 ft.

CASING RECORD:

3 - 2 in. pipes manafolded

FINISH:

Perforated from 15 to 18 ft.

AQUIFERS:

WATER LEVEL:

8 ft.

PUMPING EQUIPMENT: Type Myers Cent. H.P. 25

Capacity 600 G.P.M.

WELL TESTS:

Drawdown ft. after hours G.P.M.

Drawdown ft. after hours G.P.M.

USE OF WATER Irrigation Temp. °F. 19

SOURCE OF INFORMATION G. R. Record

DRILLER or DIGGER

ADDITIONAL DATA:

Log N.A. Water Level Measurements Chemical Analysis Aquifer Test

REMARKS:

Irrigation of 18.2 acres.