

STATE ENGINEER
Salem, Oregon

LANE
8158

Well Record

GR- 1603

STATE WELL NO. 16/4W-24H
COUNTY Lane
APPLICATION NO. GR-1638

OWNER: Walter C. & Ethel Mae Chase


MAILING ADDRESS: Rt. 2

LOCATION OF WELL: Owner's No. #1

CITY AND STATE: Eugene, Oregon

SE 1/4 NE 1/4 Sec. 24 T. 16 S., R. 4 W., W.M.

Bearing and distance from section or subdivision corner 590' N. 50°W. from E 1/4 cor. Sec. 24

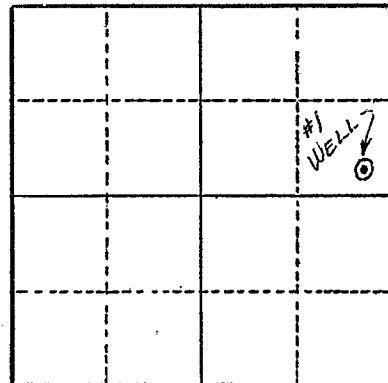

Section 24

Altitude at well 300'

TYPE OF WELL: Driven Date Constructed 1943

Depth drilled 18' Depth cased 18'

CASING RECORD:

3 - 2" pipes located 6' apart manifolded

FINISH:

Perforated with torch slots from 15 to 18 ft.

AQUIFERS:

Sand & gravel

WATER LEVEL:

7'

PUMPING EQUIPMENT: Type F. M. H.P. 7 1/2

Capacity 200 G.P.M.

WELL TESTS:

Drawdown ft. after hours G.P.M.

Drawdown ft. after hours G.P.M.

USE OF WATER Irrigation Temp. °F., 19

SOURCE OF INFORMATION GR Record

DRILLER or DIGGER

ADDITIONAL DATA:

Log N.A. Water Level Measurements Chemical Analysis Aquifer Test

REMARKS:

Irrigation of 20.9 acres.