

LANE
8165

Well Record

GR-946

OWNER: Green Brothers

MAILING

ADDRESS: Box 72

LOCATION OF WELL: Owner's No. #5


CITY AND

STATE: Coburg, Oregon

SE 1/4 NW 1/4 Sec. 25 T. 16 S., R. 4 W., W.M.

Bearing and distance from section or subdivision

corner N63°12'W. 3038' from the E 1/4 cor. Sec 25.

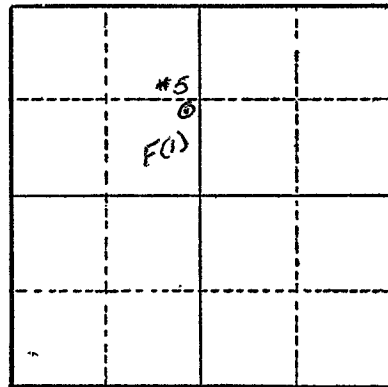

Section 25

Altitude at well 360 ft.

TYPE OF WELL: Dug Date Constructed 1951

Depth drilled 18 ft. Depth cased 18 ft.

CASING RECORD:

Open hole	0 to 6 ft.
24 in. galv. culvert	6 to 18 ft.

FINISH:

AQUIFERS:

WATER LEVEL:

12 ft.

PUMPING EQUIPMENT: Type 4" x 3" Centrifugal H.P. 20
Capacity 400 G.P.M.

WELL TESTS:

Drawdown	6	ft. after	hours	400	G.P.M.
Drawdown		ft. after	hours		G.P.M.

USE OF WATER Irrigation Temp. °F., 19

SOURCE OF INFORMATION G.R. Record

DRILLER or DIGGER

ADDITIONAL DATA:

Log Water Level Measurements Chemical Analysis Aquifer Test

REMARKS:

Log: Medium sized gravel	0 to 16 ft.
Pea gravel	16 to 18 ft.

Irrigation of 51 acres.