

STATE ENGINEER  
Salem, Oregon

# Well Record

STATE WELL NO. 16/4W-250(1)  
COUNTY Lane  
APPLICATION NO. GR-975

**LANE**  
**8166**

GR-945

OWNER: Green Brothers


MAILING ADDRESS: Box 72

LOCATION OF WELL: Owner's No. #3

CITY AND STATE: Coburg, Oregon

SW 1/4 SE 1/4 Sec. 25 T. 16 S., R. 4 W., W.M.

Bearing and distance from section or subdivision corner S37°15'W. 2448 ft. from the E 1/4 cor. Sec. 25.

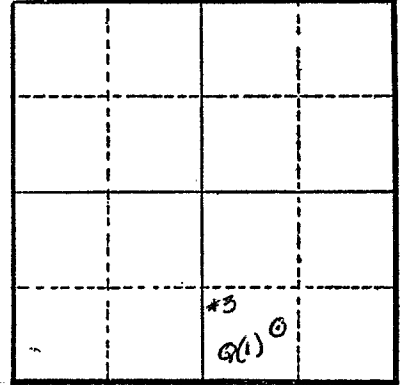

Section 25

Altitude at well 368 ft.

TYPE OF WELL: Dug Date Constructed 1951

Depth drilled 18 ft. Depth cased 18 ft.

### CASING RECORD:

Open hole 0 to 6 ft.  
24 in. galvanized culvert 6 to 18 ft.

### FINISH:

### AQUIFERS:

### WATER LEVEL:

6 ft.

PUMPING EQUIPMENT: Type 4" x 3" Centrifugal H.P. 20

Capacity 400 G.P.M.

### WELL TESTS:

Drawdown 5 ft. after 400 hours G.P.M.

Drawdown \_\_\_\_\_ ft. after \_\_\_\_\_ hours G.P.M.

USE OF WATER Irrigation Temp. \_\_\_\_\_ °F., 19\_\_\_\_\_

SOURCE OF INFORMATION G.R. Record

DRILLER or DIGGER \_\_\_\_\_

### ADDITIONAL DATA:

Log \_\_\_\_\_ Water Level Measurements \_\_\_\_\_ Chemical Analysis \_\_\_\_\_ Aquifer Test \_\_\_\_\_

### REMARKS:

Log: Medium sized gravel 0 to 16 ft.  
Pea gravel 16 to 18 ft.

Irrigation of 53 acres.