

STATE ENGINEER
Salem, Oregon

LANE
8173

Well Record

STATE WELL NO. 16/44-26B
COUNTY Lane
APPLICATION NO. GR-1759


GR- 1704

OWNER: Gordon F. Kelso
MAILING ADDRESS: Rt. 3

LOCATION OF WELL: Owner's No. #2
CITY AND STATE: Junction City, Oregon

NW 1/4 NE 1/4 Sec. 26 T. 16 S., R. 4 W., W.M.

Bearing and distance from section or subdivision
corner 2100' W. & 1232' S. from NE cor. Sec. 26

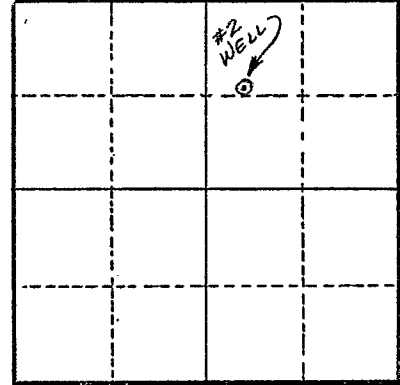

Section 26

Altitude at well 315'

TYPE OF WELL: Driven Date Constructed 1948

Depth drilled 28' Depth cased 28'

CASING RECORD:

2 - 4" pipes 6' apart

FINISH:

Standard perforations from 25 to 28 ft.

AQUIFERS:

WATER LEVEL:

PUMPING EQUIPMENT: Type Bingham Cent. H.P. Tractor
Capacity 400 G.P.M.

WELL TESTS:

Drawdown 2 ft. after hours 400 G.P.M.
Drawdown ft. after hours G.P.M.

USE OF WATER Irrigation Temp. °F. 19

SOURCE OF INFORMATION GR Record

DRILLER or DIGGER

ADDITIONAL DATA:

Log Water Level Measurements Chemical Analysis Aquifer Test

REMARKS:

Log: Loam 0 to 6 ft.
Sand & gravel 6 to 22 ft.

Irrigation of 35 acres.