

STATE ENGINEER
Salem, Oregon

LANE Well Record
8174


STATE WELL NO. 16/4W-26C
COUNTY Lane
APPLICATION NO. GR-4201

OWNER: Edmund F. Schaefer MAILING ADDRESS: 750 Horn Lane

LOCATION OF WELL: Owner's No. CITY AND STATE: Eugene, Oregon

NE 1/4 NW 1/4 Sec. 26 T. 16 N. S., R. 4 W., W.M.

Bearing and distance from section or subdivision
corner 180' W. & 1200' S. from N 1/4 Cor. Sec. 26

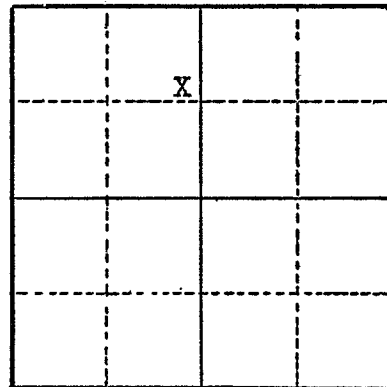

Section 26

Altitude at well

TYPE OF WELL: Driven Date Constructed 1950

Depth drilled 20 ft. Depth cased 20 ft.

CASING RECORD:

2 (3") casings from 0 to 20 feet

FINISH:

Perforated from 17 to 20 feet

AQUIFERS:

WATER LEVEL:

8 feet below surface

PUMPING EQUIPMENT: Type Fairbanks Morse centrifugal 4" x 3" H.P. 20
Capacity 300 to 500 G.P.M.

WELL TESTS:

Drawdown ft. after hours G.P.M.

Drawdown ft. after hours G.P.M.

USE OF WATER Irrigation Temp. °F., 19.....

SOURCE OF INFORMATION Well Registration Statement Cert. # GR-3744

DRILLER or DIGGER Edmund F. Schaefer, owner

ADDITIONAL DATA:

Log Water Level Measurements Chemical Analysis Aquifer Test

REMARKS: