

STATE ENGINEER
Salem, Oregon

LANE
8176

Well Record

STATE WELL NO. 16/LW-26N
COUNTY Lane
APPLICATION NO. GR-1375

GR- 1332

OWNER: Clarence & Hazel Bond


MAILING ADDRESS: 6265 River Rd.

LOCATION OF WELL: Owner's No.

CITY AND STATE: Junction City, Oregon

SW 1/4 SW 1/4 Sec. 26 T. 16 S., R. 4 W., W.M.

Bearing and distance from section or subdivision corner 1030' N. 43°20' E. from SW cor. Sec. 26

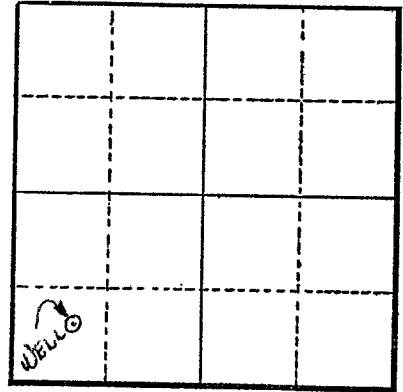

Section 26

Altitude at well 420 ft.

TYPE OF WELL: Drilled Date Constructed 1936

Depth drilled 30 ft. Depth cased 30 ft.

CASING RECORD:

12 in.

FINISH:

AQUIFERS:

WATER LEVEL:

6 ft.

PUMPING EQUIPMENT: Type Goulds 2 1/2 in. Cent. H.P. 15
Capacity 325 G.P.M.

WELL TESTS:

Drawdown 2 ft. after hours 325 G.P.M.
Drawdown ft. after hours G.P.M.

USE OF WATER Irrigation Temp. °F. 19

SOURCE OF INFORMATION G. R. Record

DRILLER or DIGGER Sloper

ADDITIONAL DATA:

Log N.A. Water Level Measurements Chemical Analysis Aquifer Test

REMARKS:

Irrigation of 46 acres/