

STATE ENGINEER  
Salem, Oregon

LANE  
8198

# Well Record

GR- 1217

STATE WELL NO. 16/4M-27A  
COUNTY Lane  
APPLICATION NO. GR- 1261


OWNER: Harold J. & Ruth I. Davis & Fred & Dorothy Brougher. ADDRESS: 4999 River Rd.

LOCATION OF WELL: Owner's No. CITY AND STATE: Junction City, Oregon

NE 1/4 NE 1/4 Sec. 27 T. 16 S., R. 4 W., W.M.

Bearing and distance from section or subdivision

corner 1 ch. S. & 19 ch. W. from NE cor. Sec. 27.

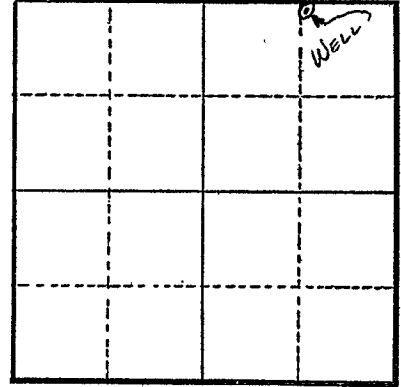

Section 27

Altitude at well

TYPE OF WELL: Driven Date Constructed 1955

Depth drilled 26 ft. Depth cased 26 ft.

### CASING RECORD:

4 inch

### FINISH:

Perforated: 2 - 1/4 x 4 in. from 20 to 26 ft.

### AQUIFERS:

### WATER LEVEL:

10 ft.

PUMPING EQUIPMENT: Type Berkeley H.P. 15  
Capacity 325 G.P.M.

### WELL TESTS:

Drawdown 15 ft. after hours 325 G.P.M.

Drawdown ft. after hours G.P.M.

USE OF WATER Irrigation Temp. °F., 19

SOURCE OF INFORMATION G. R. Record

DRILLER or DIGGER

### ADDITIONAL DATA:

Log N.A. Water Level Measurements Chemical Analysis Aquifer Test

### REMARKS:

Irrigation of 30 acres.