

STATE ENGINEER  
Salem, Oregon

# LANE Well Record

8201

STATE WELL NO. 16/LW-27F(1)  
COUNTY Lane  
APPLICATION NO. GR-461

OWNER: Benjamin A. Masengil

MAILING ADDRESS: 439 Victory Drive


LOCATION OF WELL: Owner's No. 1

CITY AND STATE: Junction City, Oregon

SE 1/4 NW 1/4 Sec. 27 T. 16 N S. R. 4 W., W.M.

Bearing and distance from section or subdivision

corner 1835.9 ft. E. of SW cor. DLC 46

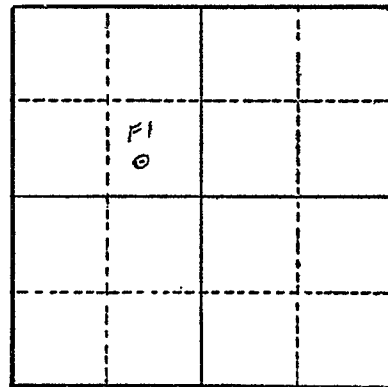

Section 27

Altitude at well 355 ft. Interpolated

TYPE OF WELL: drilled Date Constructed July 1953

Depth drilled 21 ft. Depth cased

CASING RECORD:

FINISH:

AQUIFERS:

WATER LEVEL:

PUMPING EQUIPMENT: Type H.P.  
Capacity G.P.M.

WELL TESTS:

Drawdown ft. after hours G.P.M.

Drawdown ft. after hours G.P.M.

USE OF WATER Temp. °F. 19

SOURCE OF INFORMATION

DRILLER or DIGGER

ADDITIONAL DATA:

Log Water Level Measurements Chemical Analysis Aquifer Test

REMARKS: