

STATE ENGINEER
Salem, Oregon

LANE
8204

Well Record

STATE WELL NO. 16/4W-27J
COUNTY Lane
APPLICATION NO. GR-2350

OWNER: Melvin Short


MAILING ADDRESS: 257 W. 17th St.

LOCATION OF WELL: Owner's No.

CITY AND STATE: Eugene, Oregon

NE 1/4 SE 1/4 Sec. 27 T. 16 N S, R. 4 E W., W.M.

Bearing and distance from section or subdivision corner 990' S. & 1200' W.

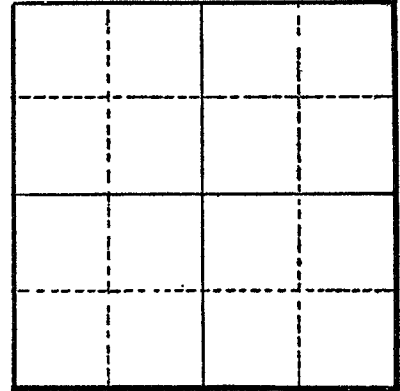

Section

Altitude at well

TYPE OF WELL: driven Date Constructed 1936

Depth drilled 22 Depth cased

CASING RECORD:

FINISH:

AQUIFERS: Dirt & gravel

WATER LEVEL: 8 ft.

PUMPING EQUIPMENT: Type Unitype centrifugal H.P. 5
Capacity 100 G.P.M.

WELL TESTS:

Drawdown 0 ft. after hours pumping 100 G.P.M.
Drawdown ft. after hours G.P.M.

USE OF WATER irrigation Temp. °F. 19

SOURCE OF INFORMATION GR-2233

DRILLER or DIGGER

ADDITIONAL DATA:

Log X Water Level Measurements Chemical Analysis Aquifer Test

REMARKS:

Log: Dirt 8 ft.
Gravel, water bearing 14 ft. to 22 ft.