

STATE ENGINEER
Salem, Oregon

LANE
8206

Well Record


STATE WELL NO. 16/4W-27K
COUNTY Lane
APPLICATION NO. GR-2266

OWNER: Roy M. Cunningham
MAILING ADDRESS: Junction City,

LOCATION OF WELL: Owner's No. _____
CITY AND STATE: Junction City, Oregon

1/4 Sec. 27 T. 16 S., R. 4 W., W.M.

Bearing and distance from section or subdivision
corner 1631.51 feet West and 320 feet South
from the E 1/4 Corner, Section 27.

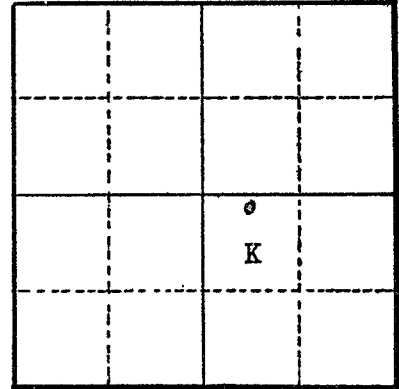

Section 27

Altitude at well 300 feet

TYPE OF WELL: dows Date Constructed 1952

Depth drilled 23 feet Depth cased _____

CASING RECORD:

4-inch casing

FINISH:

AQUIFERS:

gravel

WATER LEVEL:

8 to 10 feet

PUMPING EQUIPMENT: Type 4-inch suction H.P. _____
Capacity 2" discharge G.P.M. _____

WELL TESTS:

Drawdown _____ ft. after _____ hours _____ G.P.M.
Drawdown _____ ft. after _____ hours _____ G.P.M.

USE OF WATER Irrigation Temp. _____ °F., 19

SOURCE OF INFORMATION GR-4017

DRILLER or DIGGER _____

ADDITIONAL DATA:

Log Water Level Measurements _____ Chemical Analysis _____ Aquifer Test _____

REMARKS:

Gravel formation standard 4-inch pipe