

STATE ENGINEER  
Salem, Oregon

LANE  
8207

# Well Record

STATE WELL NO. 16/4W-27 & 34  
COUNTY LANE  
APPLICATION NO. GR-2750

OWNER: Minnie B. Plank


MAILING ADDRESS: 6370 River Road

LOCATION OF WELL: Owner's No.

CITY AND STATE: Junction City, Oregon

SE 1/4 SE 1/4 Sec. 27, 34 T. 16 N. S., R. 4 W., W.M.

Bearing and distance from section or subdivision corner 660' W.

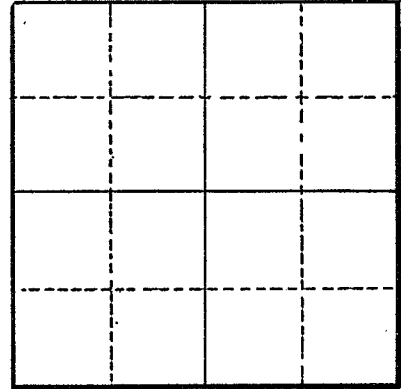

Section

Altitude at well

TYPE OF WELL: driven Date Constructed 1940

Depth drilled 24 to 26 Depth cased 26

### CASING RECORD:

3 (3")

### FINISH:

### AQUIFERS:

### WATER LEVEL:

15-feet

PUMPING EQUIPMENT: Type Bingham Centrifugal H.P. 5  
Capacity 120 G.P.M.

### WELL TESTS:

Drawdown ft. after hours G.P.M.

Drawdown ft. after hours G.P.M.

USE OF WATER irrigation Temp. °F., 19

SOURCE OF INFORMATION GR-2601

DRILLER or DIGGER Martin F. Myers

### ADDITIONAL DATA:

Log Water Level Measurements Chemical Analysis Aquifer Test

### REMARKS: