

STATE ENGINEER  
Salem, Oregon

LANE  
8208

# Well Record

STATE WELL NO. 16/LW-27K  
COUNTY Lane  
APPLICATION NO. GR-3406

OWNER: Charles V. & Catherine F. Grimes


MAILING ADDRESS: 300 Lassen Lane

LOCATION OF WELL: Owner's No.

CITY AND STATE: Junction City, Oregon

NW 1/4 SE 1/4 Sec. 27 T. 16 N. S. R. 4 W., W.M.

Bearing and distance from section or subdivision corner 2200' W. and 700' S.

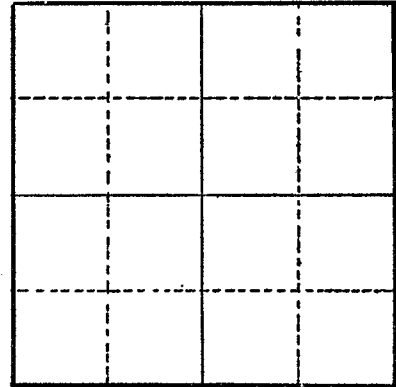

Section

Altitude at well

TYPE OF WELL: drove Date Constructed 1951

Depth drilled 21' Depth cased 21'

### CASING RECORD:

3"

### FINISH:

40, 3/8" perforations from bottom to 3 1/2' up

### AQUIFERS:

dirt, gravel

### WATER LEVEL:

7'

PUMPING EQUIPMENT: Type Fairbanks Morse Cent. H.P. 15

Capacity 300 G.P.M.

### WELL TESTS:

Drawdown 1 ft. after hours pumping 300 G.P.M.

Drawdown ft. after hours G.P.M.

USE OF WATER Irrigation Temp. °F., 19

SOURCE OF INFORMATION GR-3152

DRILLER or DIGGER owner

### ADDITIONAL DATA:

Log  Water Level Measurements Chemical Analysis Aquifer Test

### REMARKS:

dirt 4'  
gravel 17' unknown