

LANE
8224

Well Record

OWNER: Howard Humphrey

MAILING ADDRESS: 5200 Prairie Rd.


LOCATION OF WELL: Owner's No.

CITY AND STATE: Junction City, Oregon

NW 1/4 NE 1/4 Sec. 28 T. 16 S., R. 4 W., W.M.

Bearing and distance from section or subdivision

corner W. 2320' S. 340'

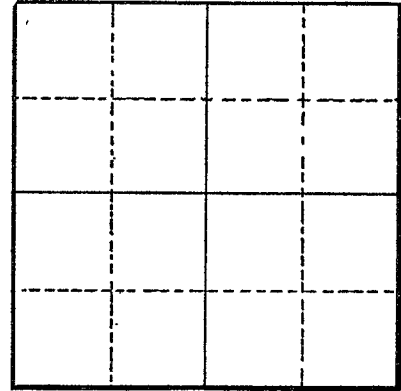

Section

Altitude at well

TYPE OF WELL: Drilled Date Constructed 1945

Depth drilled 60 Depth cased 40

CASING RECORD:

6-inch

FINISH:

AQUIFERS:

WATER LEVEL:

10-feet

PUMPING EQUIPMENT: Type Fairbanks Morse Centrifugal H.P. 5
Capacity 120 G.P.M.

WELL TESTS:
Drawdown 10 ft. after hours Pumping 120 G.P.M.
Drawdown ft. after hours G.P.M.

USE OF WATER Irrigation Temp. °F., 19

SOURCE OF INFORMATION GR-2209

DRILLER or DIGGER Wayne Hayes, 535 Coburg Rd.

ADDITIONAL DATA:

Log Water Level Measurements Chemical Analysis Aquifer Test

REMARKS: