

STATE ENGINEER  
Salem, Oregon

LANE  
8232

# Well Record

GR- 1154

STATE WELL NO. 16/4W-28G(1)  
COUNTY Lane  
APPLICATION NO. GR- 1193

OWNER: P. F. Witham

MAILING

ADDRESS: 4885 Prairie Rd.

LOCATION OF WELL: Owner's No.


CITY AND

STATE: Junction City, Oregon

SW 1/4 NE 1/4 Sec. 28 T. 16 N. S., R. 4 E. W., W.M.

Bearing and distance from section or subdivision

corner 2200' S. & 1640' W from NE cor. Sec. 28.

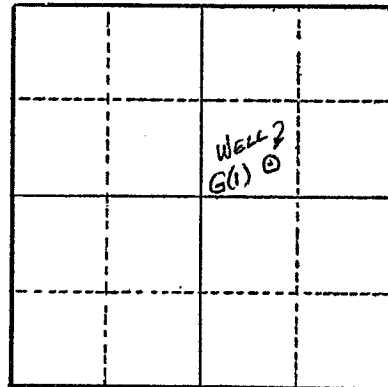

Altitude at well 355 ft.

TYPE OF WELL: Driven Date Constructed 1949

Depth drilled 17 ft. Depth cased 17 ft.

Section 28

## CASING RECORD:

2 - 2 in.

## FINISH:

3 - 3 in. slot perforations from 15 to 17 ft.

## AQUIFERS:

## WATER LEVEL:

7 1/2 ft.

PUMPING EQUIPMENT: Type Ingersol 1 1/2 x 2 in. H.P. 5  
Capacity G.P.M.

## WELL TESTS:

Drawdown ft. after hours G.P.M.

Drawdown ft. after hours G.P.M.

USE OF WATER Irrigation Temp. °F. 19

SOURCE OF INFORMATION G. R. Record

DRILLER or DIGGER

## ADDITIONAL DATA:

Log N.A. Water Level Measurements Chemical Analysis Aquifer Test

## REMARKS:

Irrigation of 10 acres.