

LANE
8251


Well Record

OWNER: Bart Flanagan
MAILING ADDRESS: Route 2

LOCATION OF WELL: Owner's No.
CITY AND STATE: Junction City, Oregon

SE 1/4 NE 1/4 Sec. 29 T. 16 N. S., R. 4 E. W., W.M.

Bearing and distance from section or subdivision corner 778' W and 46' N

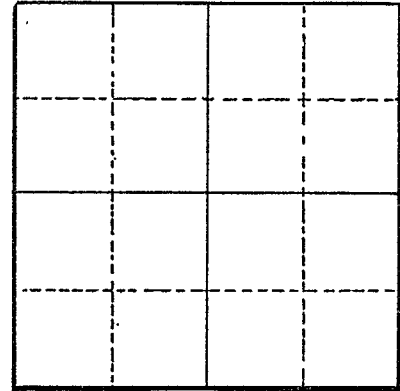

Altitude at well

TYPE OF WELL: Drilled Date Constructed 1937

Depth drilled 44 Depth cased 44

Section

CASING RECORD:

4-inch

FINISH:

Perforations from 10 to 44

AQUIFERS:

Clay, sand and loam and gravel

WATER LEVEL:

12-feet

PUMPING EQUIPMENT: Type Berkley Centrifugal H.P. 5
Capacity 170 G.P.M.

WELL TESTS:

Drawdown 7 ft. after hours Pumping 170 G.P.M.
Drawdown ft. after hours G.P.M.

USE OF WATER Irrigation Temp. °F. 19

SOURCE OF INFORMATION GR-2003

DRILLER or DIGGER

ADDITIONAL DATA:

Log Water Level Measurements Chemical Analysis Aquifer Test

REMARKS:

