

STATE ENGINEER  
Salem, Oregon

LANE  
8254

# Well Record

GR- 1247

STATE WELL NO. 16/4W-30-G  
COUNTY Lane  
APPLICATION NO. GR- 1290

OWNER: George & Rose Danielson

MAILING

ADDRESS: Rt. 2

LOCATION OF WELL: Owner's No.


CITY AND

STATE: Junction City, Oregon

SW  $\frac{1}{4}$  NE  $\frac{1}{4}$  Sec. 30 T. 16 S., R. 4 W., W.M.

Bearing and distance from section or subdivision

corner 2200' W. & 300' N. from E $\frac{1}{4}$  cor. Sec. 30

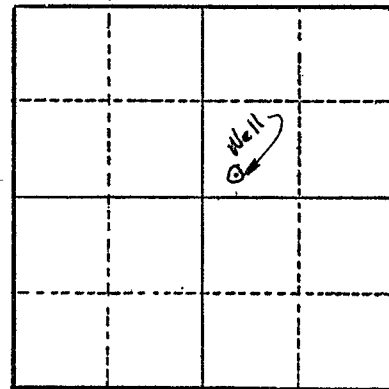

Altitude at well

TYPE OF WELL: Driven Date Constructed 1953

Depth drilled 18 ft. Depth cased 18 ft.

Section 30

CASING RECORD:

2 inch

FINISH:

Perforated: Slotted 3 x 3 in. from 15 to 18 ft.

AQUIFERS:

Gravel

WATER LEVEL:

PUMPING EQUIPMENT: Type Co-op 1 x 1 $\frac{1}{2}$  in.

H.P. 3

Capacity 60 G.P.M.

WELL TESTS:

Drawdown ft. after hours G.P.M.

Drawdown ft. after hours G.P.M.

USE OF WATER Irrigation Temp. °F. 19

SOURCE OF INFORMATION G. R. Record

DRILLER or DIGGER

ADDITIONAL DATA:

Log N.A. Water Level Measurements Chemical Analysis Aquifer Test

REMARKS:

Irrigation of 8 acres.