

STATE ENGINEER
Salem, Oregon

LANE
8257

Well Record

STATE WELL NO. 16/4W-29J(1)
COUNTY Lane
APPLICATION NO. GR-1207

GR- 1167

OWNER: Edith M. Moe

MAILING

ADDRESS: 655 Meadow View Rd.

LOCATION OF WELL: Owner's No.


CITY AND

STATE: Junction City, Oregon

NE 1/4 SE 1/4 Sec. 29 T. 16 S. R. 4 W., W.M.

Bearing and distance from section or subdivision

corner 2310' N. & 325' W. from SE Cor. Sec. 29.

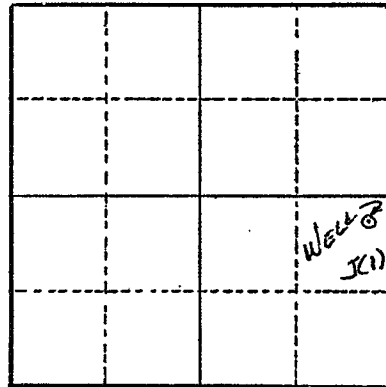

Section 29

Altitude at well 355 ft.

TYPE OF WELL: Drilled Date Constructed 1947

Depth drilled 41 ft. Depth cased 41 ft.

CASING RECORD:

6 inch

FINISH:

AQUIFERS:

WATER LEVEL:

PUMPING EQUIPMENT: Type Cent. H.P. 3

Capacity 56 G.P.M.

WELL TESTS:

Drawdown ft. after hours G.P.M.

Drawdown ft. after hours G.P.M.

USE OF WATER Irrigation Temp. °F. 19

SOURCE OF INFORMATION G. R. Record

DRILLER or DIGGER Brandt

ADDITIONAL DATA:

Log N.A. Water Level Measurements Chemical Analysis Aquifer Test

REMARKS:

Irrigation of 10.4 acres.