

STATE ENGINEER
Salem, Oregon

LANE Well Record
8263 GR- 1720

STATE WELL NO. 16/4W-30J
COUNTY Lane
APPLICATION NO. GB- 1776

OWNER: Charles E. Deming

MAILING

ADDRESS: 1665 Meadowview Rd.

LOCATION OF WELL: Owner's No.


CITY AND

STATE: Junction City, Oregon

NE $\frac{1}{4}$ SE $\frac{1}{4}$ Sec. 30 T. 16 S. R. 4 W., W.M.

Bearing and distance from section or subdivision

corner 300' W. & 300' S. from E $\frac{1}{4}$ cor. Sec. 30

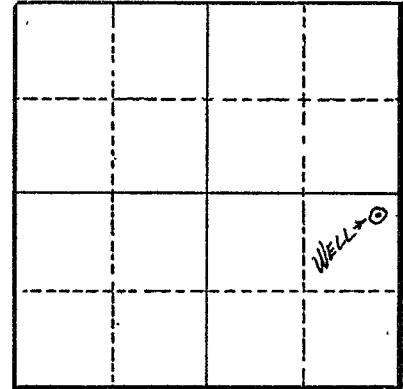

Altitude at well 354'

TYPE OF WELL: Drilled Date Constructed 1950

Depth drilled 40' Depth cased 40'

Section 30

CASING RECORD:

4"

FINISH:

Slot perforations: $\frac{1}{2}$ " x 4" (2/ft.) from 15 to 40 ft.

AQUIFERS:

WATER LEVEL:

10'

PUMPING EQUIPMENT: Type Rain-O-Flow 1 $\frac{1}{2}$ " Cent. H.P. 5

Capacity 200 G.P.M.

WELL TESTS:

Drawdown 13 ft. after July 1950 hours 150 G.P.M.

Drawdown ft. after hours G.P.M.

USE OF WATER Irrigation Temp. °F. 19

SOURCE OF INFORMATION GR Record

DRILLER or DIGGER

ADDITIONAL DATA:

Log Water Level Measurements Chemical Analysis Aquifer Test

REMARKS:

Log: Dirt 0 to 20 ft.
Gravel 20 to 40 ft.

Irrigation of 15 acres.