

LANE
8277

Well Record

STATE WELL NO. 16/LW-33N
COUNTY Lane
APPLICATION NO. GR-3390

OWNER: Elmer E. Hansen


MAILING ADDRESS: Route 1, Box 188

LOCATION OF WELL: Owner's No.

CITY AND STATE: Junction City, Oregon

SW 1/4 SW 1/4 Sec. 33 T. 16 N. S., R. 4 E. W., W.M.

Bearing and distance from section or subdivision corner 875' N. and 395' E.

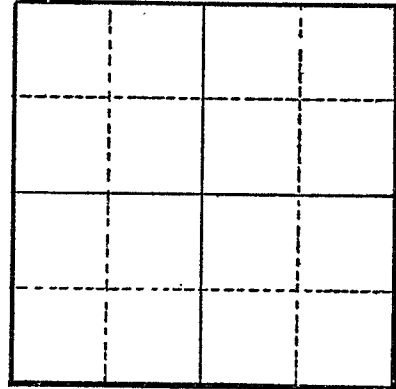

Section

Altitude at well

TYPE OF WELL: driven Date Constructed 1954

Depth drilled 19' Depth cased 19'

CASING RECORD:

3 - (2")

FINISH:

three 2" casings 12' apart "T" connected as on well standard perforations from 16 to 19

AQUIFERS:

topsoil (loam) sand and gravel

WATER LEVEL:

15'

PUMPING EQUIPMENT: Type Berkeley Gent.

H.P. 5

Capacity 160 G.P.M.

WELL TESTS:

Drawdown 3 ft. after hours pumping 100 G.P.M.

Drawdown ft. after hours G.P.M.

USE OF WATER Irrigation Temp. °F. 19

SOURCE OF INFORMATION GR-3130

DRILLER or DIGGER

ADDITIONAL DATA:

Log Water Level Measurements Chemical Analysis Aquifer Test

REMARKS:

topsoil (loam)	6'	13
sand and gravel	13	0