

STATE ENGINEER
Salem, Oregon

LANE
8278

Well Record

STATE WELL NO. 16/LW-32R(2)
COUNTY Lane
APPLICATION NO. GR-1390

GR- 1347

OWNER: Roy C. Sandborn


MAILING ADDRESS: Rt. 1, Box 191

LOCATION OF WELL: Owner's No. #1

CITY AND STATE: Eugene, Oregon

SE 1/4 SE 1/4 Sec. 32 T. 16 S., R. 4 W., W.M.

Bearing and distance from section or subdivision corner 465' N. & 1100' W. from SE cor. Sec. 32

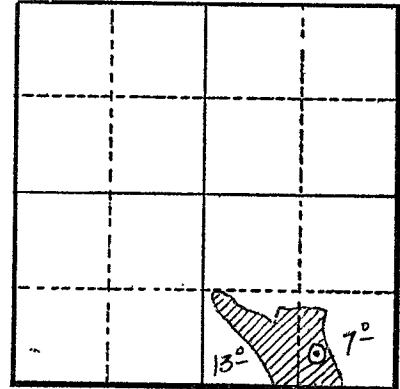

Section 32

Altitude at well 340 ft.

TYPE OF WELL: Dug Date Constructed 1951

Depth drilled 18 ft. Depth cased

CASING RECORD:

FINISH:

AQUIFERS:

WATER LEVEL:

6 ft.

PUMPING EQUIPMENT: Type Berkeley 1 1/2 in. Cent. H.P. 7 1/2

Capacity 250 G.P.M.

WELL TESTS:

Drawdown ft. after hours G.P.M.

Drawdown ft. after hours G.P.M.

USE OF WATER Irrigation Temp. °F. 19

SOURCE OF INFORMATION G. R. Record

DRILLER or DIGGER

ADDITIONAL DATA:

Log N.A. Water Level Measurements Chemical Analysis Aquifer Test

REMARKS:

Irrigation of 20 acres.