

STATE ENGINEER
Salem, Oregon

LANE
8313

Well Record

STATE WELL NO. 16/LW-34G
COUNTY LANE
APPLICATION NO. GR-3678

OWNER: Charles E. Defoe


MAILING ADDRESS: Box 127

LOCATION OF WELL: Owner's No. 2

CITY AND STATE: Harbor, Oregon

SW 1/4 NE 1/4 Sec. 34 T. 16 S., R. 4 W., W.M.

Bearing and distance from section or subdivision corner 1625' W & 150' N from E¹/₄ cor Sec 34

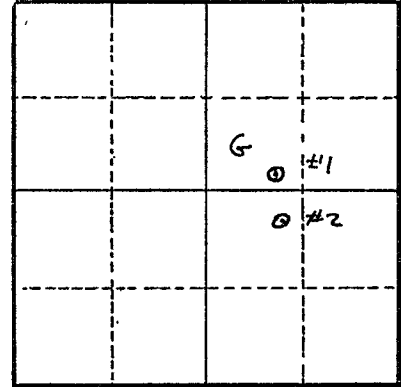

Section 34

Altitude at well _____

TYPE OF WELL: Drilled Date Constructed 1952

Depth drilled _____ Depth cased _____

CASING RECORD:

8-inch

FINISH:

AQUIFERS:

WATER LEVEL:

PUMPING EQUIPMENT: Type Tudeim H.P. 7 1/2
Capacity 150 G.P.M.

WELL TESTS:

Drawdown _____ ft. after _____ hours _____ G.P.M.
Drawdown _____ ft. after _____ hours _____ G.P.M.

USE OF WATER Irrigation Temp. _____ °F. _____, 19____

SOURCE OF INFORMATION GR-3925

DRILLER or DIGGER _____

ADDITIONAL DATA:

Log NA Water Level Measurements _____ Chemical Analysis _____ Aquifer Test _____

REMARKS: