

STATE ENGINEER
Salem, Oregon

LANE
8314

Well Record

STATE WELL NO. 16/LW-34K
COUNTY LANE
APPLICATION NO. GR-3216

OWNER: Charles E. Defoe


MAILING ADDRESS: Box 122

LOCATION OF WELL: Owner's No.

CITY AND STATE: Harbor, Oregon

NW 1/4 SE 1/4 Sec. 34 T. 16 S., R. 4 W., W.M.

Bearing and distance from section or subdivision corner 1625' W & 450' S from E 1/4 Cor. Sec. 34

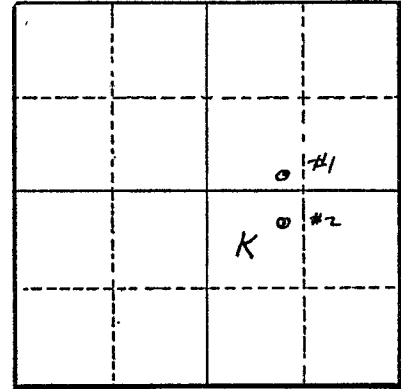

Section 34

Altitude at well

TYPE OF WELL: Drilled Date Constructed 1952

Depth drilled Depth cased

CASING RECORD:

FINISH:

AQUIFERS:

WATER LEVEL: NA

PUMPING EQUIPMENT: Type Tudeim H.P. 7 1/2
Capacity 150 G.P.M.

WELL TESTS:
Drawdown ft. after hours G.P.M.
Drawdown ft. after hours G.P.M.

USE OF WATER Irrigation Temp. °F., 19

SOURCE OF INFORMATION GR-3935

DRILLER or DIGGER

ADDITIONAL DATA:

Log NA Water Level Measurements Chemical Analysis Aquifer Test

REMARKS: