

STATE ENGINEER  
Salem, Oregon

**LANE** Well Record  
**8344**

STATE WELL NO. 16/LW-35E  
COUNTY Lane  
APPLICATION NO. GR-3121

OWNER: Mary Abrams


MAILING ADDRESS: 6777 River Road

LOCATION OF WELL: Owner's No. \_\_\_\_\_

CITY AND STATE: Junction City, Oregon

SW 1/4 NW 1/4 Sec. 35 T. 16 S., R. 4 W., W.M.

Bearing and distance from section or subdivision corner 19.97 chains South and 7.15 chains East of NW Corner of Sec. 35.

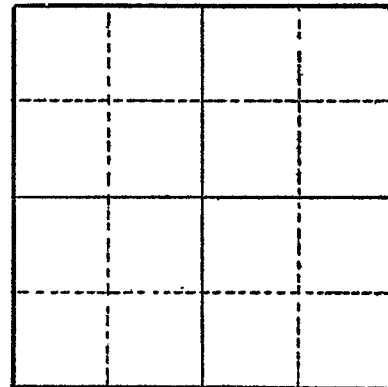

Section \_\_\_\_\_

Altitude at well \_\_\_\_\_

TYPE OF WELL: Driven Date Constructed 1944

Depth drilled 20' Depth cased 20'

CASING RECORD:

Tied (2"  
2")

FINISH:

perforated slots from 17 to 20

AQUIFERS:

WATER LEVEL:

9'

PUMPING EQUIPMENT: Type Fairbanks Morse H.P. 3  
Capacity 60 G.P.M.

WELL TESTS:

Drawdown \_\_\_\_\_ ft. after \_\_\_\_\_ hours \_\_\_\_\_ G.P.M.

Drawdown \_\_\_\_\_ ft. after \_\_\_\_\_ hours \_\_\_\_\_ G.P.M.

USE OF WATER Irrigation Temp. \_\_\_\_\_ °F., 19 \_\_\_\_\_

SOURCE OF INFORMATION GR-2928

DRILLER or DIGGER D. D. Dickinson, 1280 River Road, Eugene, Oregon

ADDITIONAL DATA:

Log \_\_\_\_\_ Water Level Measurements \_\_\_\_\_ Chemical Analysis \_\_\_\_\_ Aquifer Test \_\_\_\_\_

REMARKS: