

STATE ENGINEER  
Salem, Oregon

**LANE** Well Record  
**8345**

STATE WELL NO. 16/4W-35E  
COUNTY LANE  
APPLICATION NO. GR-2475

OWNER: Charles E. Smith

MAILING

ADDRESS: 7015 River Road,

LOCATION OF WELL: Owner's No. \_\_\_\_\_


CITY AND

STATE: Junction City, Oregon

SW 1/4 NW 1/4 Sec. 35 T. 16 S., R. 4 W., W.M.

Bearing and distance from section or subdivision

corner 0.64 ch. N. & 12.65 ch. E.

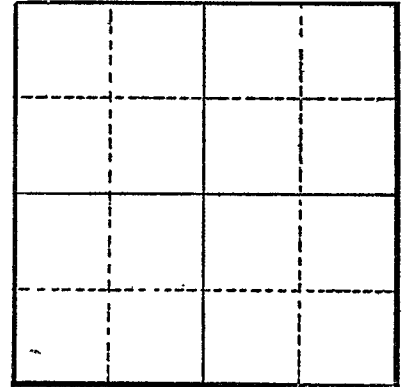

Section \_\_\_\_\_

Altitude at well \_\_\_\_\_

TYPE OF WELL: Driven Date Constructed 1944

Depth drilled 20 Depth cased 20

CASING RECORD:

2 - 2"

FINISH:

Slotted or perforated bottom 4'

AQUIFERS:

Soil, loam, gravel and sand

WATER LEVEL:

15-feet

PUMPING EQUIPMENT: Type Fairbanks Morse Centrifugal H.P. \_\_\_\_\_

Capacity \_\_\_\_\_ G.P.M.

WELL TESTS:

Drawdown 3 ft. after \_\_\_\_\_ hours Pumping 60 G.P.M.

Drawdown \_\_\_\_\_ ft. after \_\_\_\_\_ hours \_\_\_\_\_ G.P.M.

USE OF WATER Irrigation Temp. \_\_\_\_\_ °F. \_\_\_\_\_, 19\_\_\_\_

SOURCE OF INFORMATION GR-2344

DRILLER or DIGGER \_\_\_\_\_

ADDITIONAL DATA:

Log X Water Level Measurements \_\_\_\_\_ Chemical Analysis \_\_\_\_\_ Aquifer Test \_\_\_\_\_

REMARKS:

12' Soil and loam                      12      12  
8' Gravel and sand                      8        20