

STATE ENGINEER
Salem, Oregon

LANE 8347
Well Record


STATE WELL NO. 16/4W-35J
COUNTY Lane
APPLICATION NO. GR-4086

OWNER: Edith K. Carr MAILING ADDRESS: 735 Beacon Drive

LOCATION OF WELL: Owner's No. CITY AND STATE: Oregon

NE 1/4 SE 1/4 Sec. 35 T. 16 S., R. 4 W., W.M.

Bearing and distance from section or subdivision corner

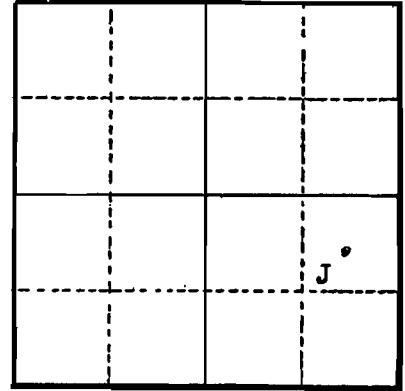

Altitude at well sea level

TYPE OF WELL: Drilled Date Constructed 1952

Depth drilled 25 feet Depth cased

Section 35

CASING RECORD:

FINISH:

AQUIFERS:

gravel

WATER LEVEL:

13 feet

PUMPING EQUIPMENT: Type Fairbanks-Morse H.P.

Capacity 100 G.P.M.

WELL TESTS:

Drawdown 3 ft. after 100 hours G.P.M.

Drawdown ft. after hours G.P.M.

USE OF WATER Irrigation Temp. °F., 19

SOURCE OF INFORMATION GR-4029

DRILLER or DIGGER

ADDITIONAL DATA:

Log X Water Level Measurements Chemical Analysis Aquifer Test

REMARKS:

8-9 feet to gravel