

STATE ENGINEER  
Salem, Oregon

**LANE**  
**8352** Well Record

STATE WELL NO. 16/4W-35J(1)  
COUNTY Lane  
APPLICATION NO. GR-653

OWNER: Wintfred D. Gann


MAILING ADDRESS: 739 Beacon Drive

LOCATION OF WELL: Owner's No. 1

CITY AND STATE: Eugene, Oregon

NE 1/4 SE 1/4 Sec. 35 T. 16 S., R. 4 W., W.M.

Bearing and distance from section or subdivision  
corner S. 20° 12' W. 2074.5 ft. from John Brown  
DLC 44

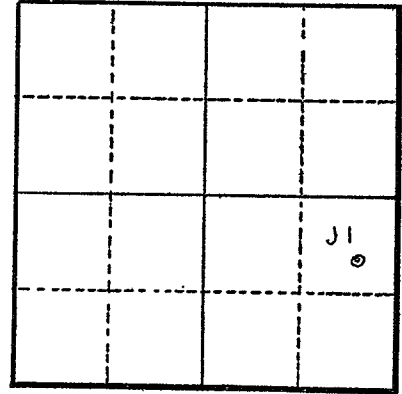

Section 35

Altitude at well 370 ft. Interpolated

TYPE OF WELL: drilled Date Constructed

Depth drilled 26 Depth cased 26

CASING RECORD: 6 inch

FINISH:

AQUIFERS:

WATER LEVEL: 12 ft.

PUMPING EQUIPMENT: Type centrifugal H.P. 20  
Capacity 500 G.P.M.

WELL TESTS:  
Drawdown ft. after hours G.P.M.  
Drawdown ft. after hours G.P.M.

USE OF WATER irrigation 16.6 acres Temp. °F. 19

SOURCE OF INFORMATION GR-653

DRILLER or DIGGER

ADDITIONAL DATA:

Log Water Level Measurements Chemical Analysis Aquifer Test

REMARKS: